


# 1ST FLOOR


10,149 RSF AVAILABLE FOR LEASE

Suite 101 - 8,450 SF AVAILABLE

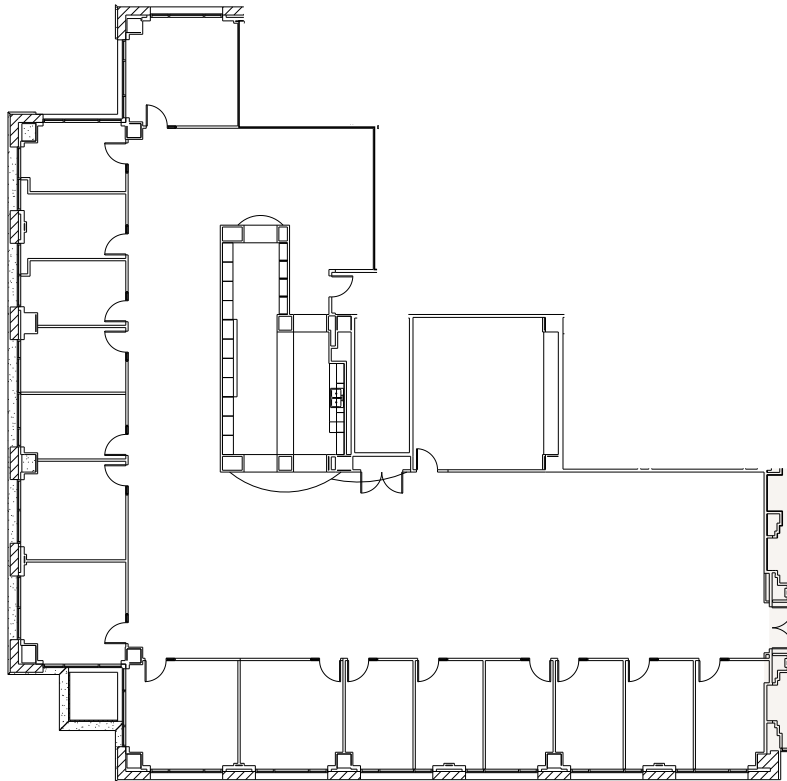

Suite 195 - 1,699 SF AVAILABLE

As Built

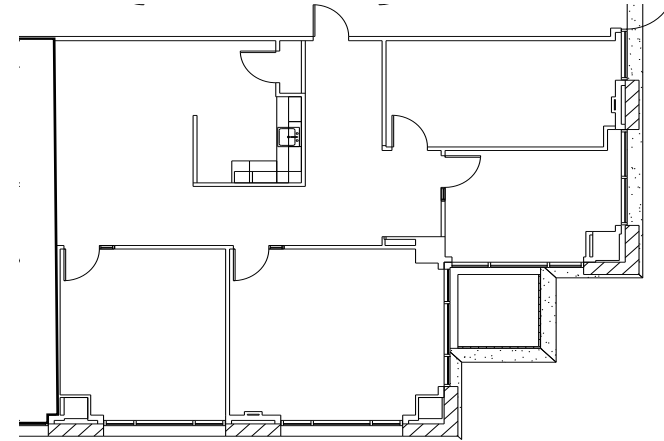

Spec Plan

